

PIANO PRIMO - scala 1:200

The floor plan shows a complex layout of a winery. Key areas include:


- Top Left:** A row of 11 circular storage tanks labeled HL.1228 + (1) through (11).
- Top Center:** A row of 11 circular storage tanks labeled HL.910 + (1) through (11).
- Top Right:** A row of 11 circular storage tanks labeled HL.800 + (6) and (7), and HL.1508 + (13) through (20).
- Left Wing:** Rooms labeled CAMERA, BAGNO, STUDIO, WC, CUCINA, and SOGGIORNO.
- Central Area:** A large open space with a staircase and a row of 11 circular storage tanks labeled HL.620 + (1) through (4).
- Right Wing:** Rooms labeled CAMERA, BAGNO, CUCINA, and SOGGIORNO.
- Bottom Left:** A row of 11 circular storage tanks labeled HL.925 + (19) through (22).
- Bottom Center:** A row of 11 circular storage tanks labeled HL.1000 + (1) through (11).
- Bottom Right:** A row of 11 circular storage tanks labeled HL.1188 + (13) through (22).
- Legend:**
 - Red square: SILOS VINAI
 - Red line: COCIGA TRASPORTO
 - Blue square: SILOS FECC
 - Blue line: COCIGA TRASPORTO

Data: 21.07.2015

TAVOLA A

PIANO TERRA - scala 1:200

Vasche

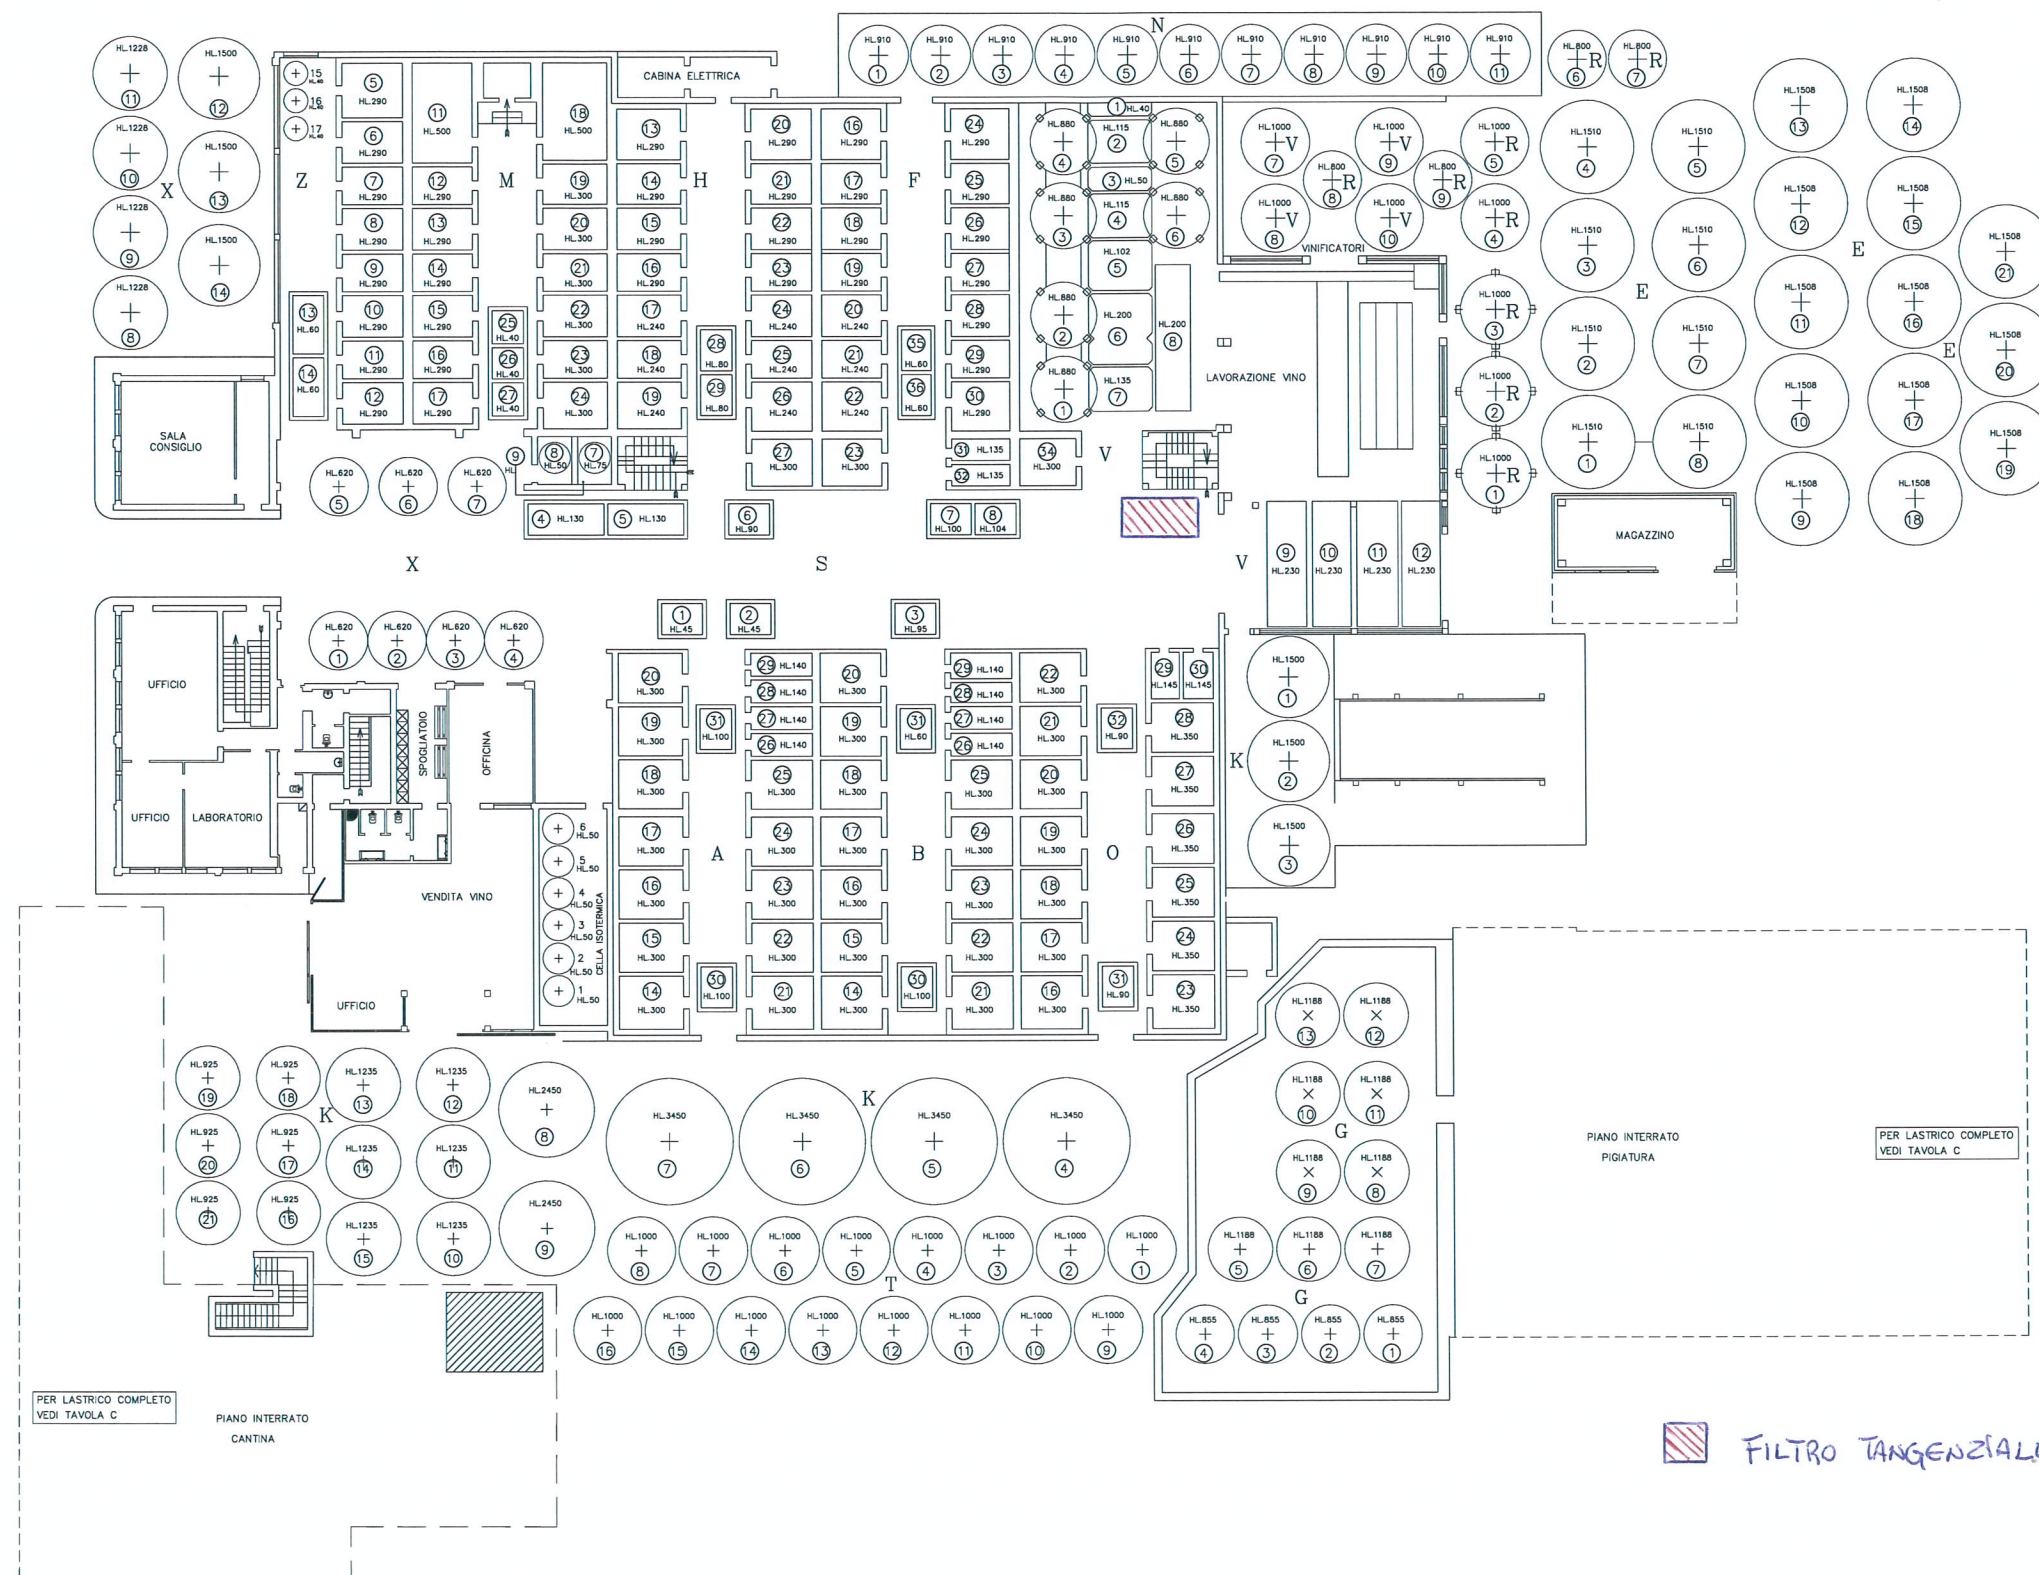

Data: 21.07.2015